

"Empire Island"

ex

SS. "West Kedron"

Baltimore Report No. 7159


Capacity Plan



© 2020

Lloyd's Register
Foundation

W1130-0154

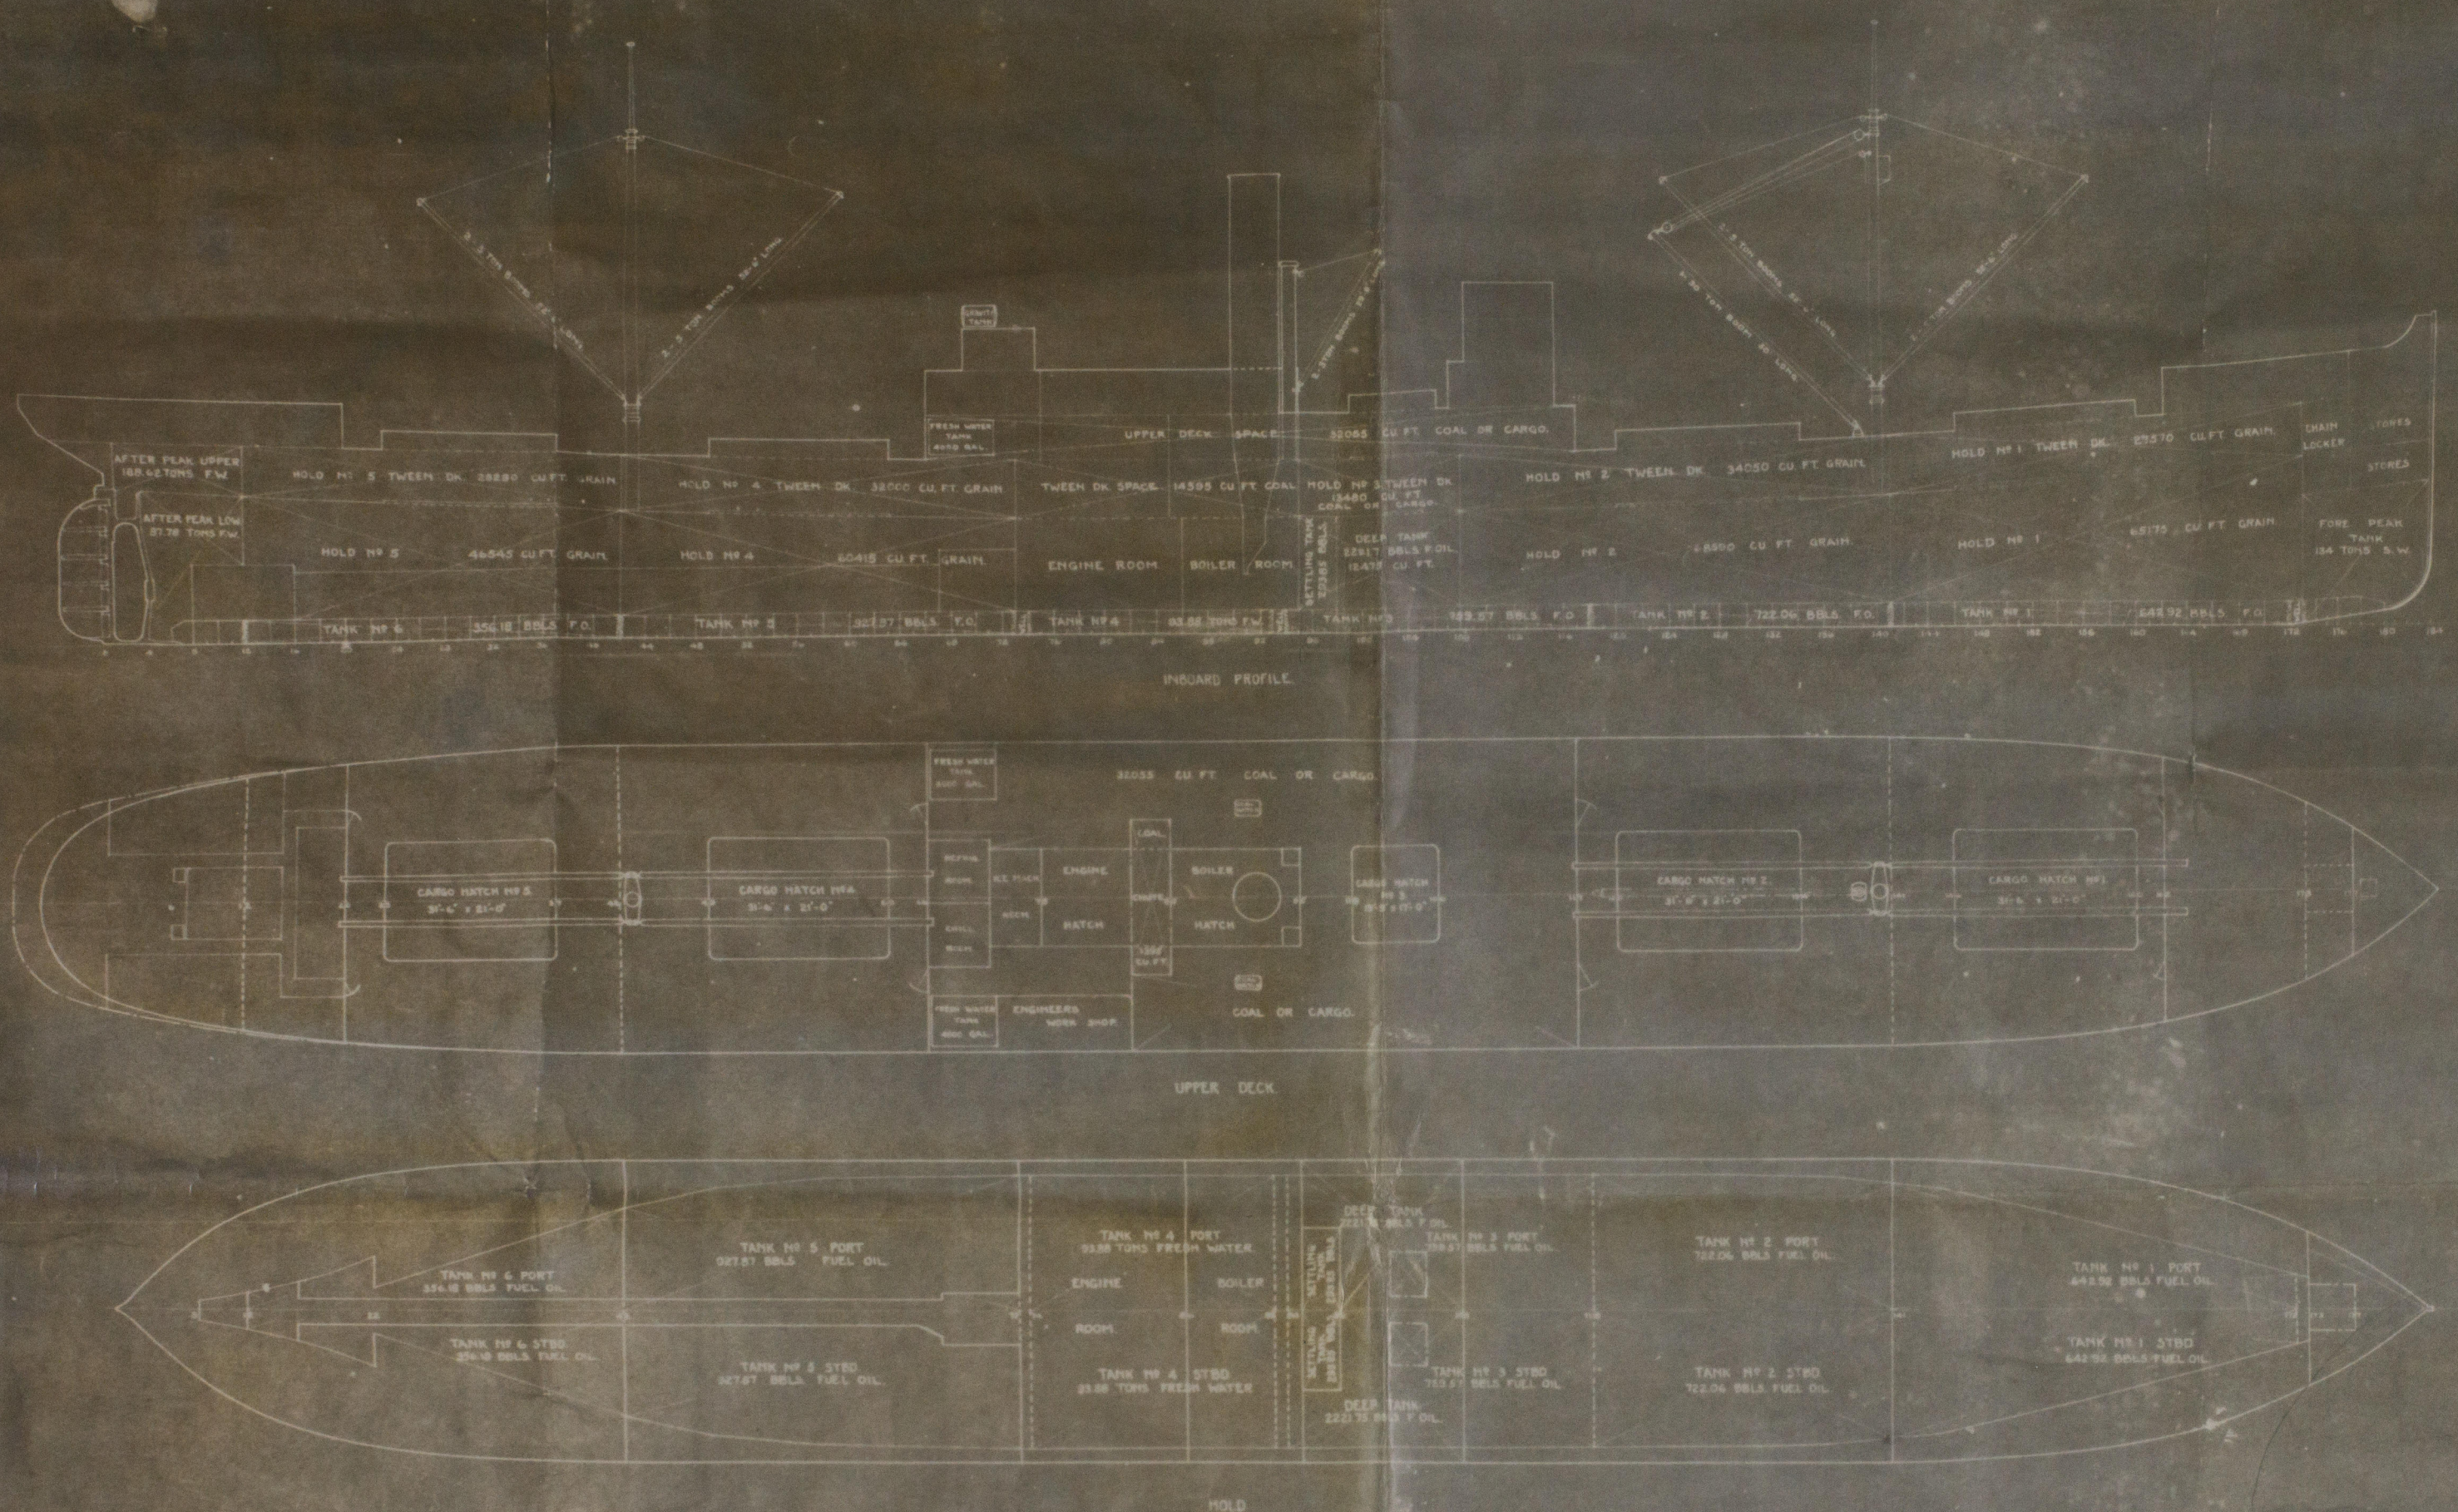

CAPACITY SCALE				

GRADUATED SCALE OF TANKS									

CARGO SPACE CAPACITIES				
COMPARTMENT	LOCATION	GRAIN - CU. FT.	BALE - CU. FT.	
HOLD NO. 1 LOWER	141 - 173	65,772	61,900	
HOLD NO. 2 LOWER	108 - 141	58,989	56,072	
HOLD NO. 4 LOWER	42 - 73	50,415	47,550	
HOLD NO. 5 LOWER	12 - 42	46,545	42,740	
HOLD NO. 1 TWEEN DEK	141 - 173	27,570	25,980	
HOLD NO. 2 TWEEN DEK	108 - 141	24,050	22,735	
HOLD NO. 3 TWEEN DEK	85 - 108	15,480	13,020	
HOLD NO. 4 TWEEN DEK	42 - 73	32,000	30,820	
HOLD NO. 5 TWEEN DEK	12 - 42	28,280	26,805	
UPPER DECK SPACE	66 - 117	32,055	30,600	
TOTAL		408,160	387,520	

HATCH CAPACITIES		
HATCH	LOCATION	CU. FT.
HATCH NO. 1	UPPER DEK	2350
HATCH NO. 2	UPPER DEK	2350
HATCH NO. 3	BRIDGE DEK	550
HATCH NO. 4	UPPER DEK	2350
HATCH NO. 5	UPPER DEK	2350
TOTAL		9950

COAL BUNKER CAPACITIES				
PERMANENT BUNKERS				
SPACE	LOCATION	CU. FT.	TONS	
TWEEN DECK	73 - 95	14,599	324.33	
TWEEN DECK	95 - 108	13,450	299.50	
RESERVE BUNKERS				
UPPER DECK	66 - 117	32,055	712.3	
COAL CHUTE	82 - 85	1,395	31.0	
TOTAL		61,525	1367.13	

DOUBLE BOTTOM TANK CAPACITIES						
IN TONS & BBLs PER 6 INCHES						
TANK NO.	PORT	STBD	TANK NO.	PORT	STBD	TANK NO.
1	94.50	642.92	106.28	722.06	111.00	789.57
2	90.70	617.02	106.02	721.28	110.34	750.66
3	84.85	578.80	91.88	625.11	97.42	660.79
4	65.18	443.45	75.45	514.45	80.10	544.31
5	51.30	349.06	59.81	406.34	62.95	428.31
6	37.35	258.23	43.97	299.19	47.07	313.44
7	24.08	163.84	28.40	193.23	29.45	200.35
8	10.96	73.90	11.12	75.65	12.32	87.26
9	0.00	0.00	0.00	0.00	0.00	0.00
10	0.00	0.00	0.00	0.00	0.00	0.00
FUEL OIL CAPACITIES & WATER BALLAST COMPNTS						
TANKS	LOCATION	CU. FT.	TONS	WATER BALLAST	TONS	
TANK NO. 1 PORT	141 - 172	3610	642.92	94.50	103.14	
TANK NO. 1 STBD	141 - 172	3610	642.92	94.50	103.14	
TANK NO. 2 PORT	118 - 141	4060	722.06	106.28	116.00	
TANK NO. 2 STBD	118 - 141	4060	722.06	106.28	116.00	
TANK NO. 3 PORT	94 - 118	4265	759.57	111.64	121.85	
TANK NO. 3 STBD	94 - 118	4265	759.57	111.64	121.85	
TANK NO. 5 PORT	42 - 73	5210	927.87	136.39	140.85	
TANK NO. 5 STBD	42 - 73	5210	927.87	136.39	140.85	
TANK NO. 6 PORT	12 - 42	2000	356.18	52.36	57.15	
TANK NO. 6 STBD	12 - 42	2000	356.18	52.36	57.15	
DEEP TANK PORT	95 - 108	12,475	2221.75	326.57	356.43	
DEEP TANK STBD	95 - 108	12,475	2221.75	326.57	356.43	
SETTLING TANK P	85 - 98	1650	293.85	43.20		
SETTLING TANK S	85 - 98	1650	293.85	43.20		
TOTAL		66,540	11,948.40	1741.88	1806.84	

WATER TANKS			
TANKS	LOCATION	CU. FT.	TONS
TANK NO. 4 PORT	74 - 93	3380	93.88
TANK NO. 4 STBD	74 - 93	3380	93.88
AFTER PEAK UPPER	0 - 12	6790	188.62
AFTER PEAK LOWER	3 - 12	3160	87.78
FORE PEAK	173 - 184	4690	134.00
TOTAL		21,400	598.16

NAME
SS WEST KEENE 2076 131
SS WEST KATAN 2077 132
SS VINITA 2078 133
SS HALEAKALA 2079 134
SS WEST KEATS 2080 135
SS WEST KEBAR 2081 136
SS WEST KEDRON 2082 137

THREE - 14'-9" DIA SCOTCH BOILERS
ONE - 2800 H.P. TRIPLE EXPANSION
RECIP. ENGINE 24 1/2 - 41 1/2 - 72 - 48.

LENGTH OVER ALL - 427'-0"
LENGTH BET PERPS - 410'-5 1/2"
BREADTH MOULDED - 54'-0"
DEPTH MLD. TO UP. DEK. 29'-9"

EMERGENCY FLEET CORP. HULL NO. 2076 - 2082
BUILDERS HULL NO. 131-137

CAPACITY PLAN
SCALE: 1/4" = 1'-0" DATE: 1/5/19
LONG BEACH SHIPBUILDING CO.
LONG BEACH, CALIFORNIA
PLAN NO. 76-B
Lloyd's Register
Foundation

[illegible]

REVERFRAMES: ON EVERY FLOOR IN DOUBLE BOTTOM
WATERWAYS 3/4" PLATE IS INCREASED TO 10" IN
WATERWAYS 1/2" PLATE. ON EVERY FRAME IN
EVERY FRAME AND IN BOILER SPACE ON ALL
PRIVATE FRAMES: ON EVERY FRAME IN BOTH
WATERWAYS 3/4" PLATE IS INCREASED TO 10" IN
ON ALL FRAMES TO 10" IN 3/4" PLATE. NO 10" PLATE
WATERWAYS 12" x 12" WITH DOUBLE PLATE BARS 3/4"
X 12" IN 10" PLATE IN ENGINE SPACE BUT
ON EVERY FRAME IN BOTH WATERWAYS 3/4" PLATE
ON ALL FRAMES HAVE BEEN INCREASED IN LIEU OF
SAME. W/ FRAMES WILL BE FITTED IN
HOLDING CONNECTION WITH PLANT IN DEAM
WATERWAYS 3/4" PLATE WILL BE FITTED IN
BRIDGE OVER BULKHEADS
W/ FRAMES IN ACCORDANCE WITH

FLOORS- ON EVERY FRAME 4"x4"x1/2" FOR 1/2" TO 3/4"
AT ENDS- INCREASED TO 50 IN BUILT UP SPACE
PIVOTS IN BOTH RAFTERS OVER ENDS- 3/4" DIA
DOORS- 3'x7'x1/2" OVER ENDS- 3/4" x 1 1/4"
ANGLES FITTED BE LONGITUDINALS AS SHOWN
CENTER VERTICAL ANGLES- 2 1/2"x2" FOR 1/2" TO 3/4" AT ENDS
AND 3"x3" FOR 3/4" TO 1 1/4" THROUGHOUT
TO GET PLATE LEVEL 5'x5' IN 1/2" THROUGHOUT
GIRDE ANGLES- 10"x10"x1/2" ON PLATING 8"x10"x1/2"
TO GET TO 10"x10" THROUGHOUT
LONGITUDINALS- TWO EACH SIDE 4"x8" FOR 1/2" TO 3/4" AT ENDS
50 IN BUILT UP SPACE- HALF DEPTH LONGITUDINAL 3"x8"
FOR 3/4" TO 1 1/4" THROUGHOUT
EXTRA FULL RIB LONGITUDINALS WILL BE FITTED
IN WAY OF ENGINE FOUNDATION AS REQUIRED
SIDE STRINGERS- 10"x10" 1/2" DIA- 50 IN BUILT UP SPACE
AND 10"x10" 3/4" DIA- 1 1/4" CLIP- 50 IN CONTINUOUS
2 1/2"x4"x1/2" PLATE ANGLE- ADDITIONAL PAINTING
STRINGERS WILL BE FITTED FORWARD
DECK- 1 1/2"x12"x1/2" FOR 1/2" TO 3/4" 2 1/2"x12"x1/2"

13007 CHANNELS, EXCEPT IN WAY OF CARGO MATCHES
 AND MACHINERY OPENINGS WHERE THEY WILL
 BE 3 X 4.5 X 4.5 OR 3 X 5 CHANNELS ON OVER
 FRAME
 UPPER DECK: ON EVERY FRAME 7 X 3.45 X 4.8 X 2.0 S
 CHANNELS IN TWO LINES, 132.5 IN. ON 2.0 IN.
 UPPER DECK: ON EVERY FRAME 7 X 3.45 X 4.8 X 2.0 S
 6" CHANNELS
 FORECASTLE DECK: ON EVERY FRAME 7 X 3.45 X
 5.0 X 2.0 S CHANNELS WITH SUPPORT EQUAL TO
 TWO ROWS OF PILLARS
 BOARDSIDE CH: ON ALTERNATE FRAMES 8 X 3.5 X 5.5
 BUSH CHANNELS, SUPPORT EQUAL TO TWO ROWS OF
 PILLARS, BEARING BRASS AT UPPER CORNERS OF
 CHANNELS AS REGULAR BEAMS
 POINT DECK BEAMS: 4 X 3 X 9.8" ANGLES SPACED

STRONG BEAMS - IN MACHINERY SPACE OF SCANTLING
AS REQUIRED
WELDED HEADS - TESTING TO BE REQUIRED THICK-
NESS IN ACCORDANCE WITH DETAIL BULKHEAD
STIFFENERS TO BE OF REQUIRED SIZE FOR 30"
SPACING GENERALLY AND FITTED WITH LUGS AT
WELDED JOINTS AND ALL WELDED JOINTS TO
BE SUBMITTED FOR APPROVAL
SHAFT TUNNEL PRESS- THICKNESS OF PLATING SIZE
AND SPACING OF STIFFENERS TO BE ACCORDING TO
STIFFENERS
SHOUL PLATING, AT STERN FRAME TO BE OF MIDSHIP
THICKNESS OF STRAKES
THREE STRAKES TO PLATE PLATE KEEL
TO MAINTAIN MIDSHIP THICKNESS TO COLLISION
BULKHEAD

DISCONTINUATION OF THICKNESSES OF PLATING ALSO
 REQUIRED. APPROVAL REQUIRED FOR ALL REQUIRED APPROVAL
 DOUBLING PLATING TO BE FILLED AT LEAST WHERE
 BRIDGE AT NAUSE PIPES AND ELSEWHERE AS
 REQUIRED.
 REPAIRS MUST BE:
 RUMPER SINGLE PLATE TYPE - FORGED FRAME
 WITH KEYS AND ALL TYPE EACH GUYEN -
 RUMPER STOCK OF WROT STEEL OF DIA.
 APPROVAL INCREASE AT KEYWAYS -
 STOCK TO BE 10% DIA. PINTLES 5% DIA. BY
 HORIZONTAL FLANGE COUPLING -
 STOCK 10% DIA. PINTLES 5% DIA. PLATE 110


-RIVETING-

ALL BUTT STRAPS, BUTTLAPS, SEAM OR EDGE LAPS
TO BE OF WIDTH AS REQUIRED AND ALL RIVET-
ING THROUGHOUT TO BE IN ACCORDANCE
WITH _____ RULES

--NOTES--
DETAIL PLANS OF THE FOLLOWING TO BE SUBMITTED
FOR APPROVAL:- STERN FRAME ,
RUDDER, ALL W.T.B.H., DEEP FUEL OIL TANK,
PANTING STRINGERS, BOW FRAMING ETC.,
PILARS & GIRDERS, HATCHES, PROFILE &
DECK PLANS, PUMPING ARRANGEMENT.

BRIDGE SIZE PLATING TO BE CARRIED DOWN TO
DECK AT ENDS AND DOUBLINGS FITTED
UPPER DECK SHEER STRAKE & STRINGER TO BE
DOUBLED OR INCREASED IN THICKNESS AT
ENDS OF BRIDGE


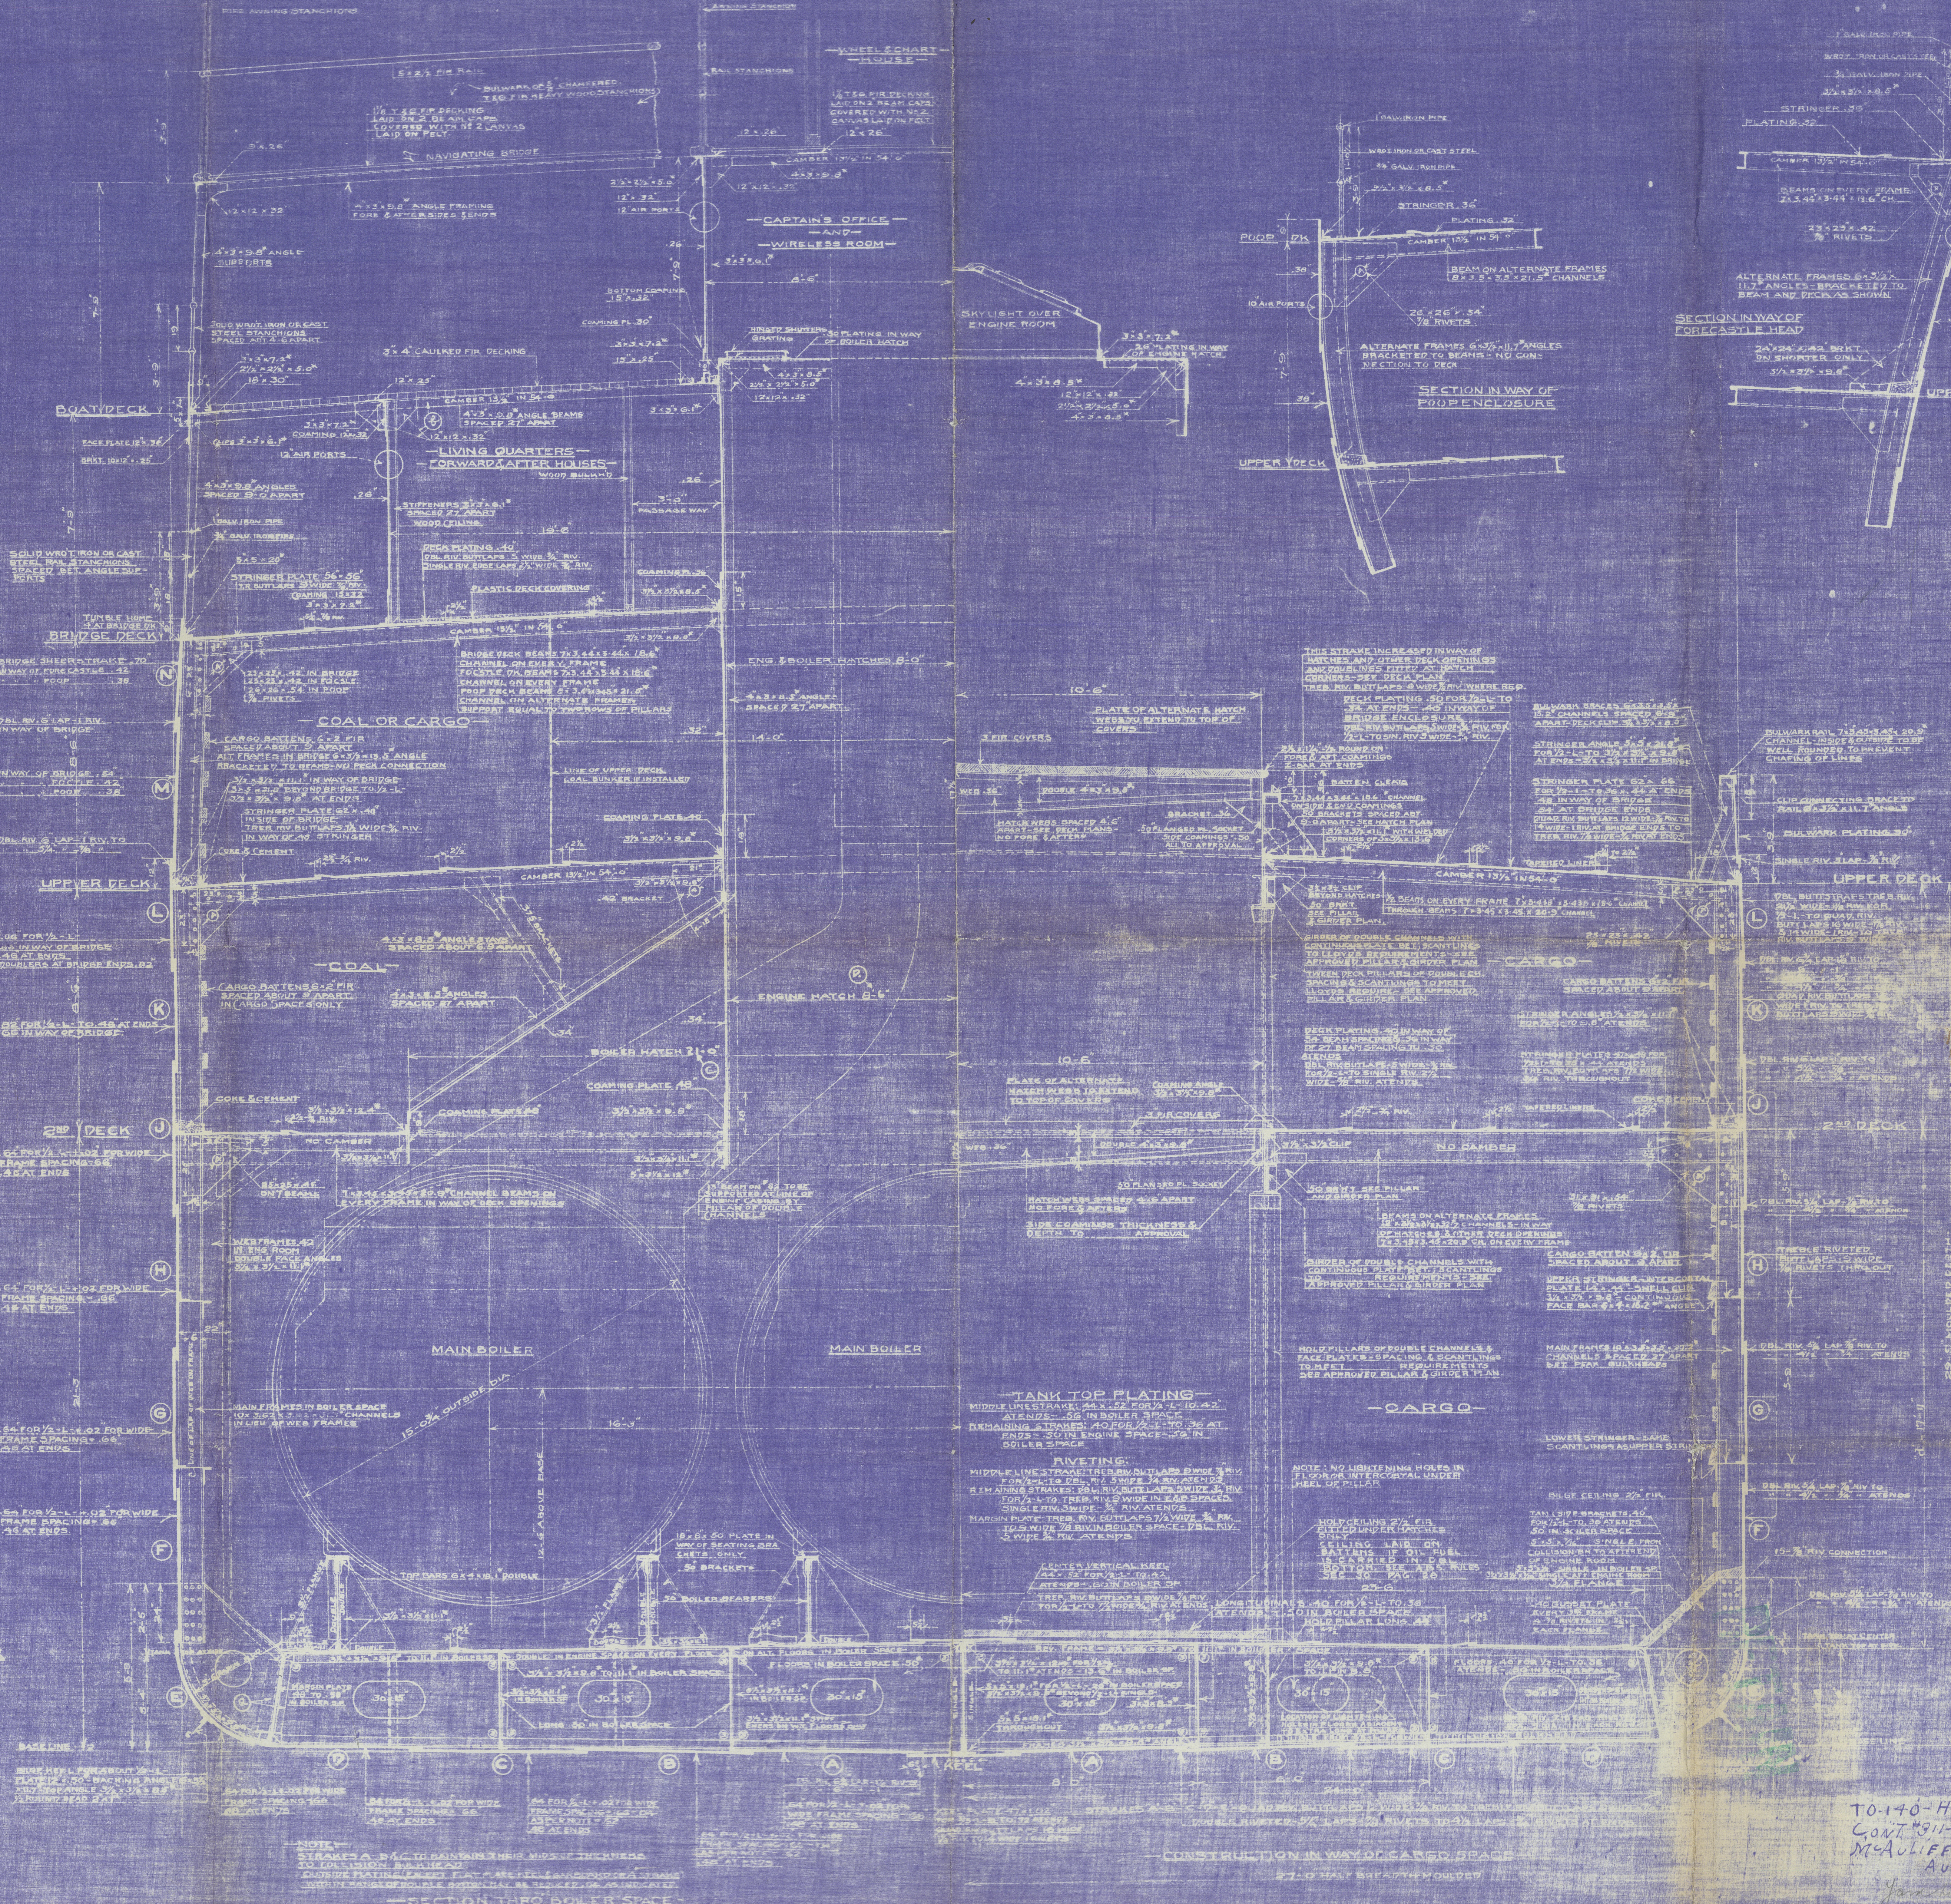

DATE	MARK	ALTERATIONS
1.5.1	C	ROLLER HATCH CHANGED TO 21-0" ON ACCOUNT OF FITTING HONDA FORD DRAFT
1.5.1	D	ENGINE HATCH CHANGED TO 21-0"

AMERICAN BUREAU OF SHIPPING		
EQUIPMENT		
2 BOWERS	STOCKLESS	7665 ⁰⁰ EACH
1 STREAM		2765 ⁰⁰
1 KEDGE		1155 ⁰⁰
20 FATHOMS	STUD STRAIN CABLE	270 ⁰⁰ EACH
90	STEEL WIRE STRAIN CHAIN	48 CIRC
120	" " " "	5 " "
2 HAWSERS	90 FATHOMS EACH	8 " "
2 WARPS	" " " "	7 " "

[illegible]

<u>EQUIPMENT NUMBER</u>	
HOUSE ON BRIDGE DECK 51-755-778-600X1-7791-45	
FURNITURE 17-154-1-99	
PRIZE 114-72-9-5-154-1	
POOP 43-72-7-7-5139-1	
	1690.5%
	13-77-9-
	13-75-7-3
	PLATING NUMBER 36-75-7-9
	EQUIPMENT 320-66-73

—EQUIPMENT—

2 LOWER ANCHORS STOCKLESS EACH 65.75 CWT
1 LOWER ANCHOR 5.15
1 STEEL 22.50
1 ANCHOR 11.50
370 PATOMS - 2 1/2" STRIP LINGERS 1.00
90 3/4" STEEL WIRE (STREAM)
120 5" TOW LINE

Baltimore Report No. 7157

— OF —
— 8800 TON RAW CARGO SHIP —
— FOR —
— CRAIG SHIP BUILDING CO. —





x x x PD "

6060
4-2075-82
ETTER
4.19.19



W1130-0155






"Empire Island"

Bal. 7159





© 2020

Lloyd's Register
Foundation

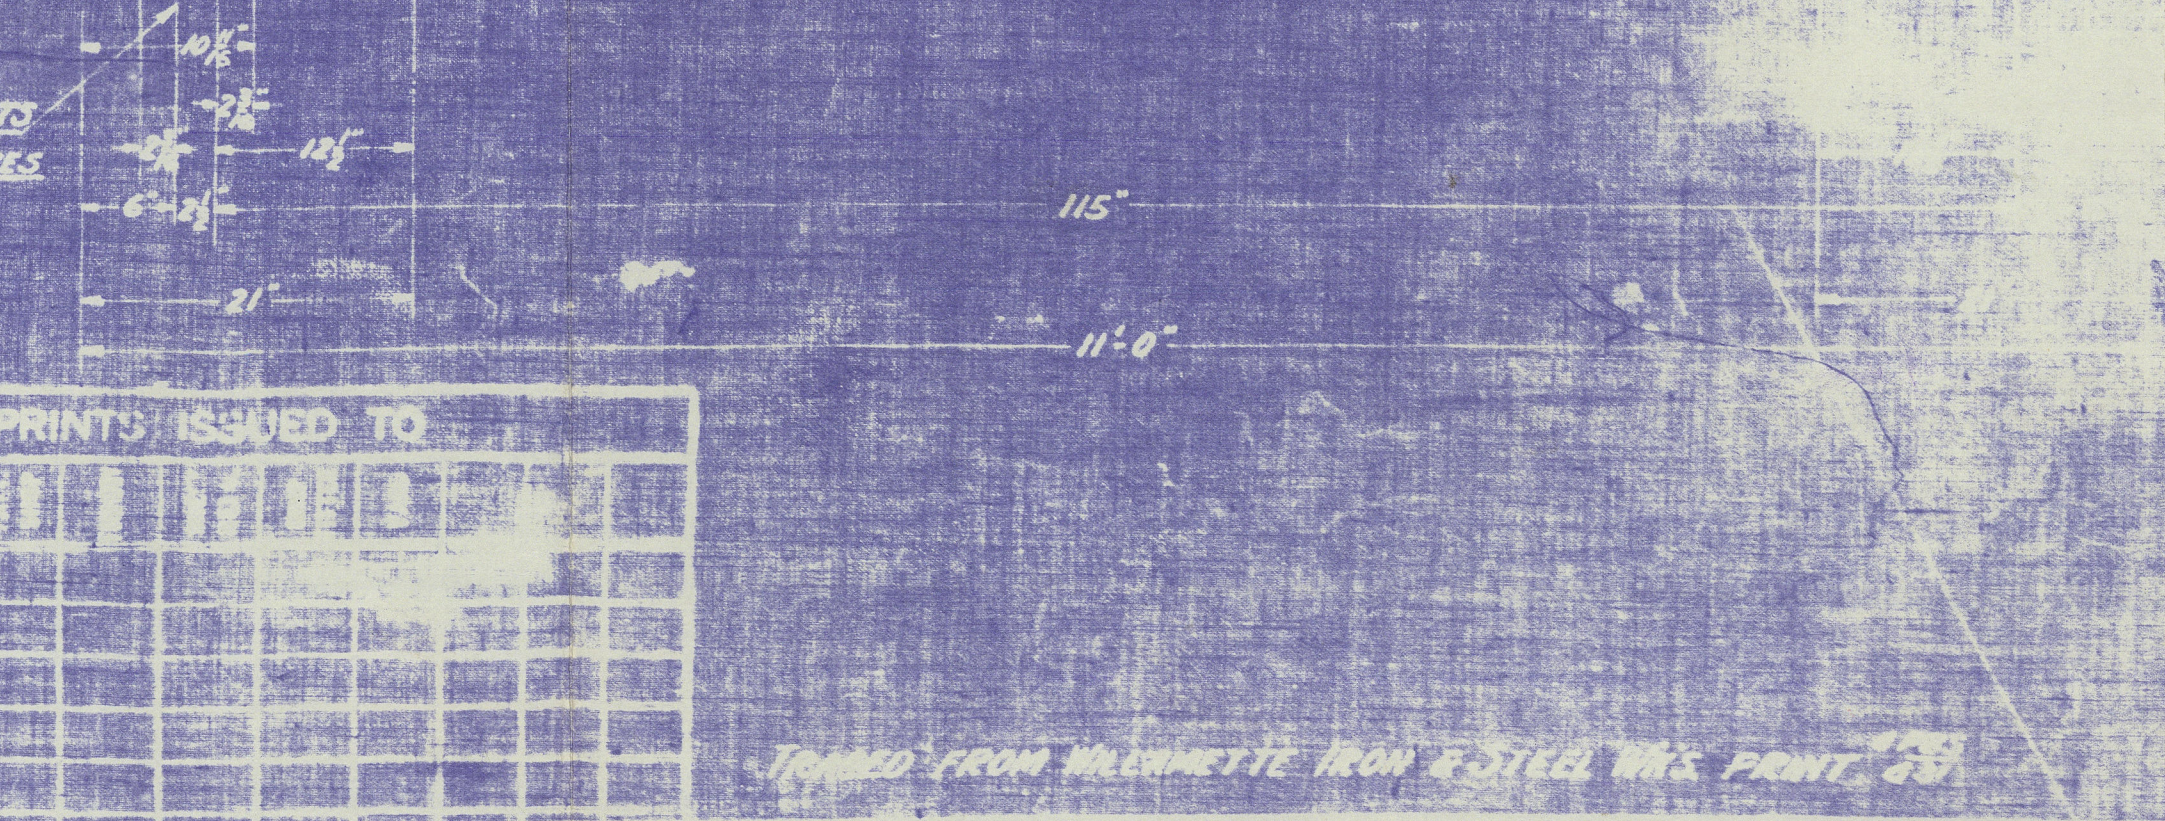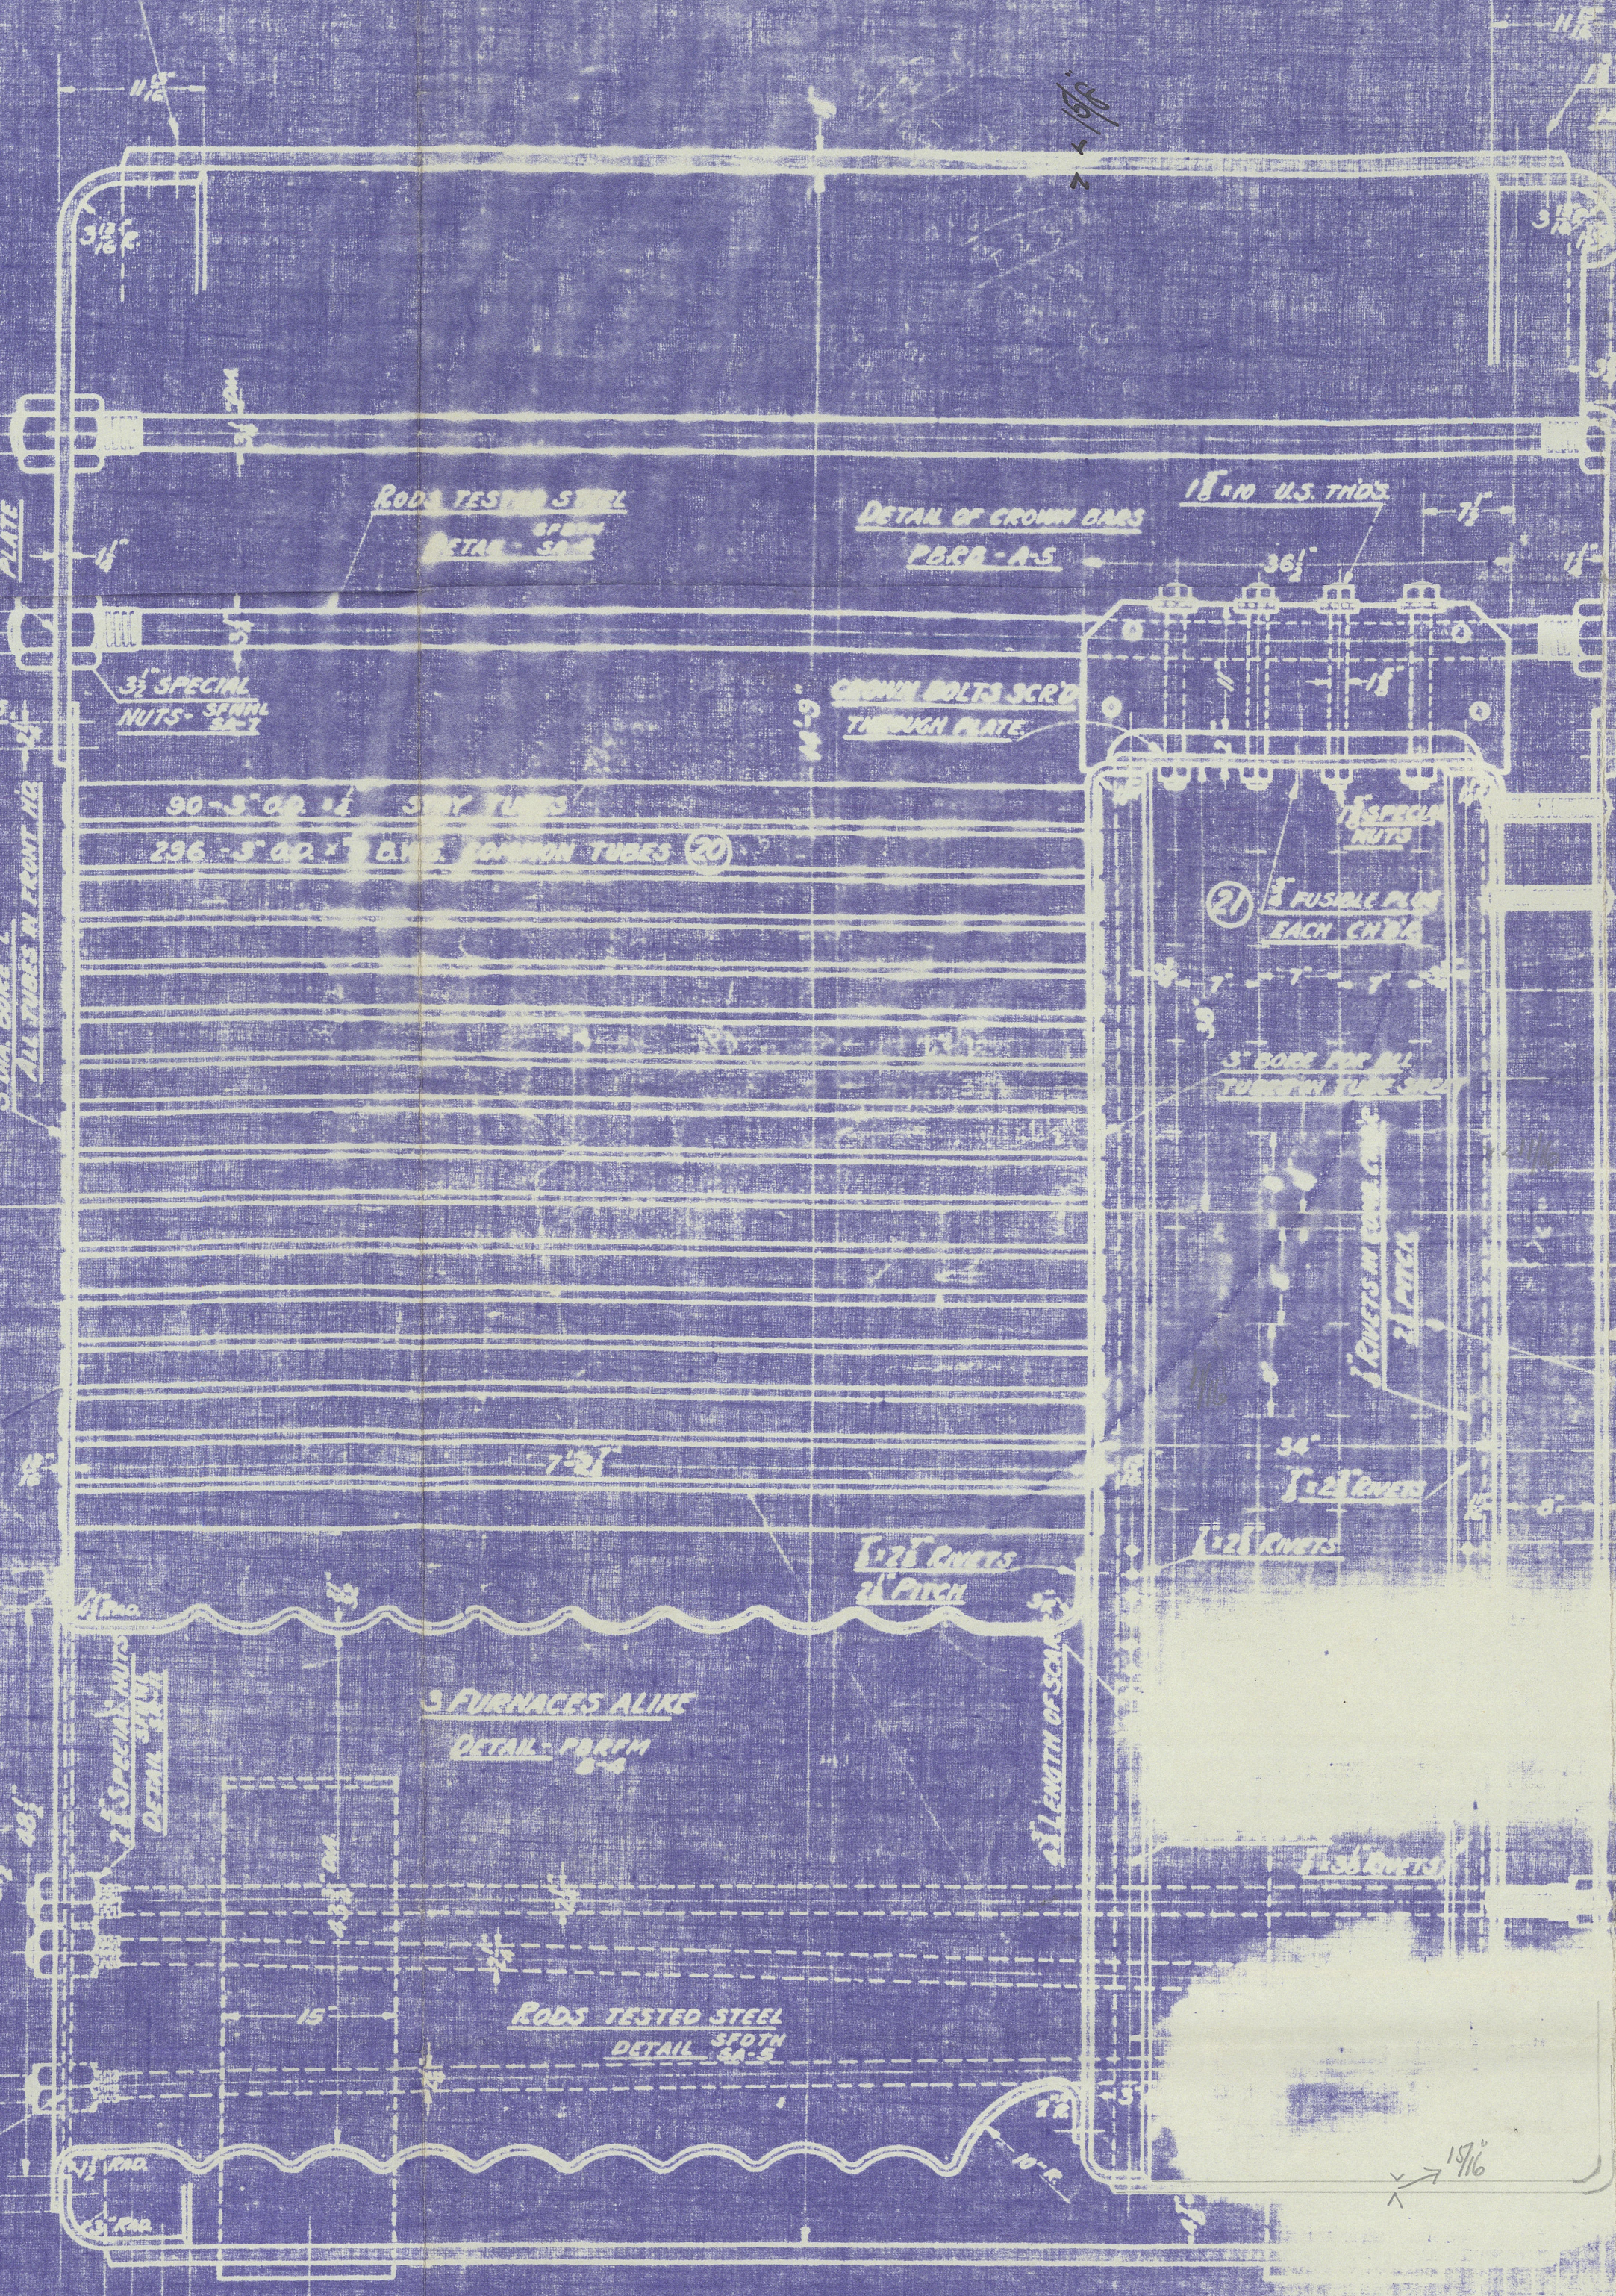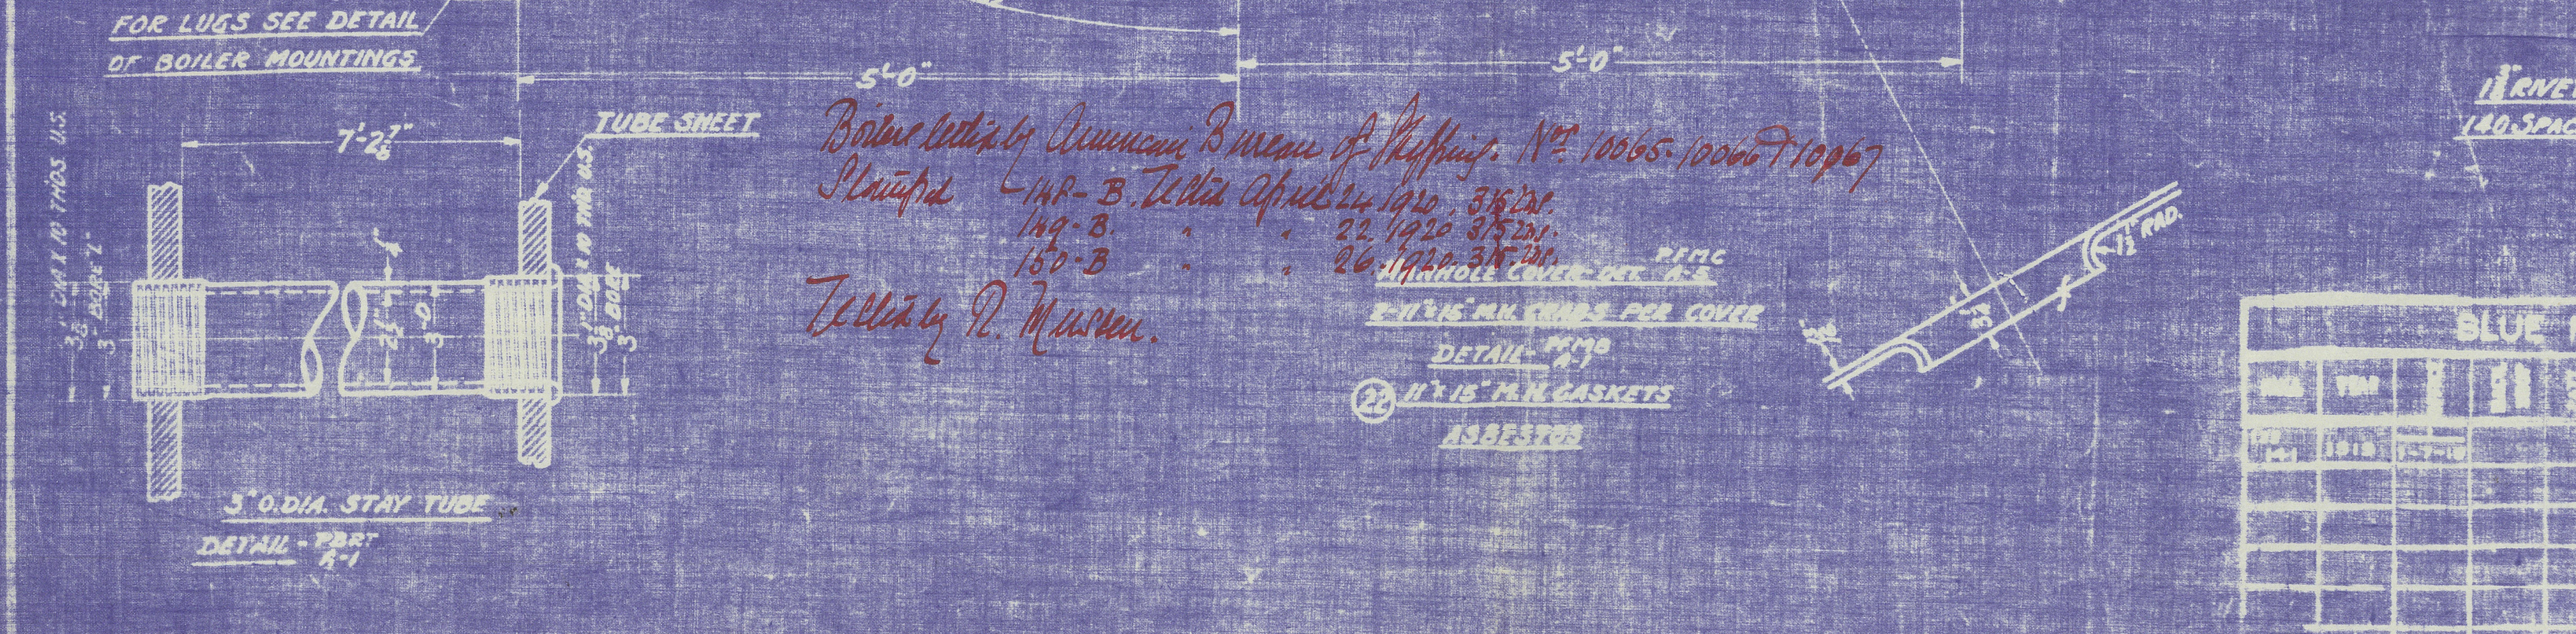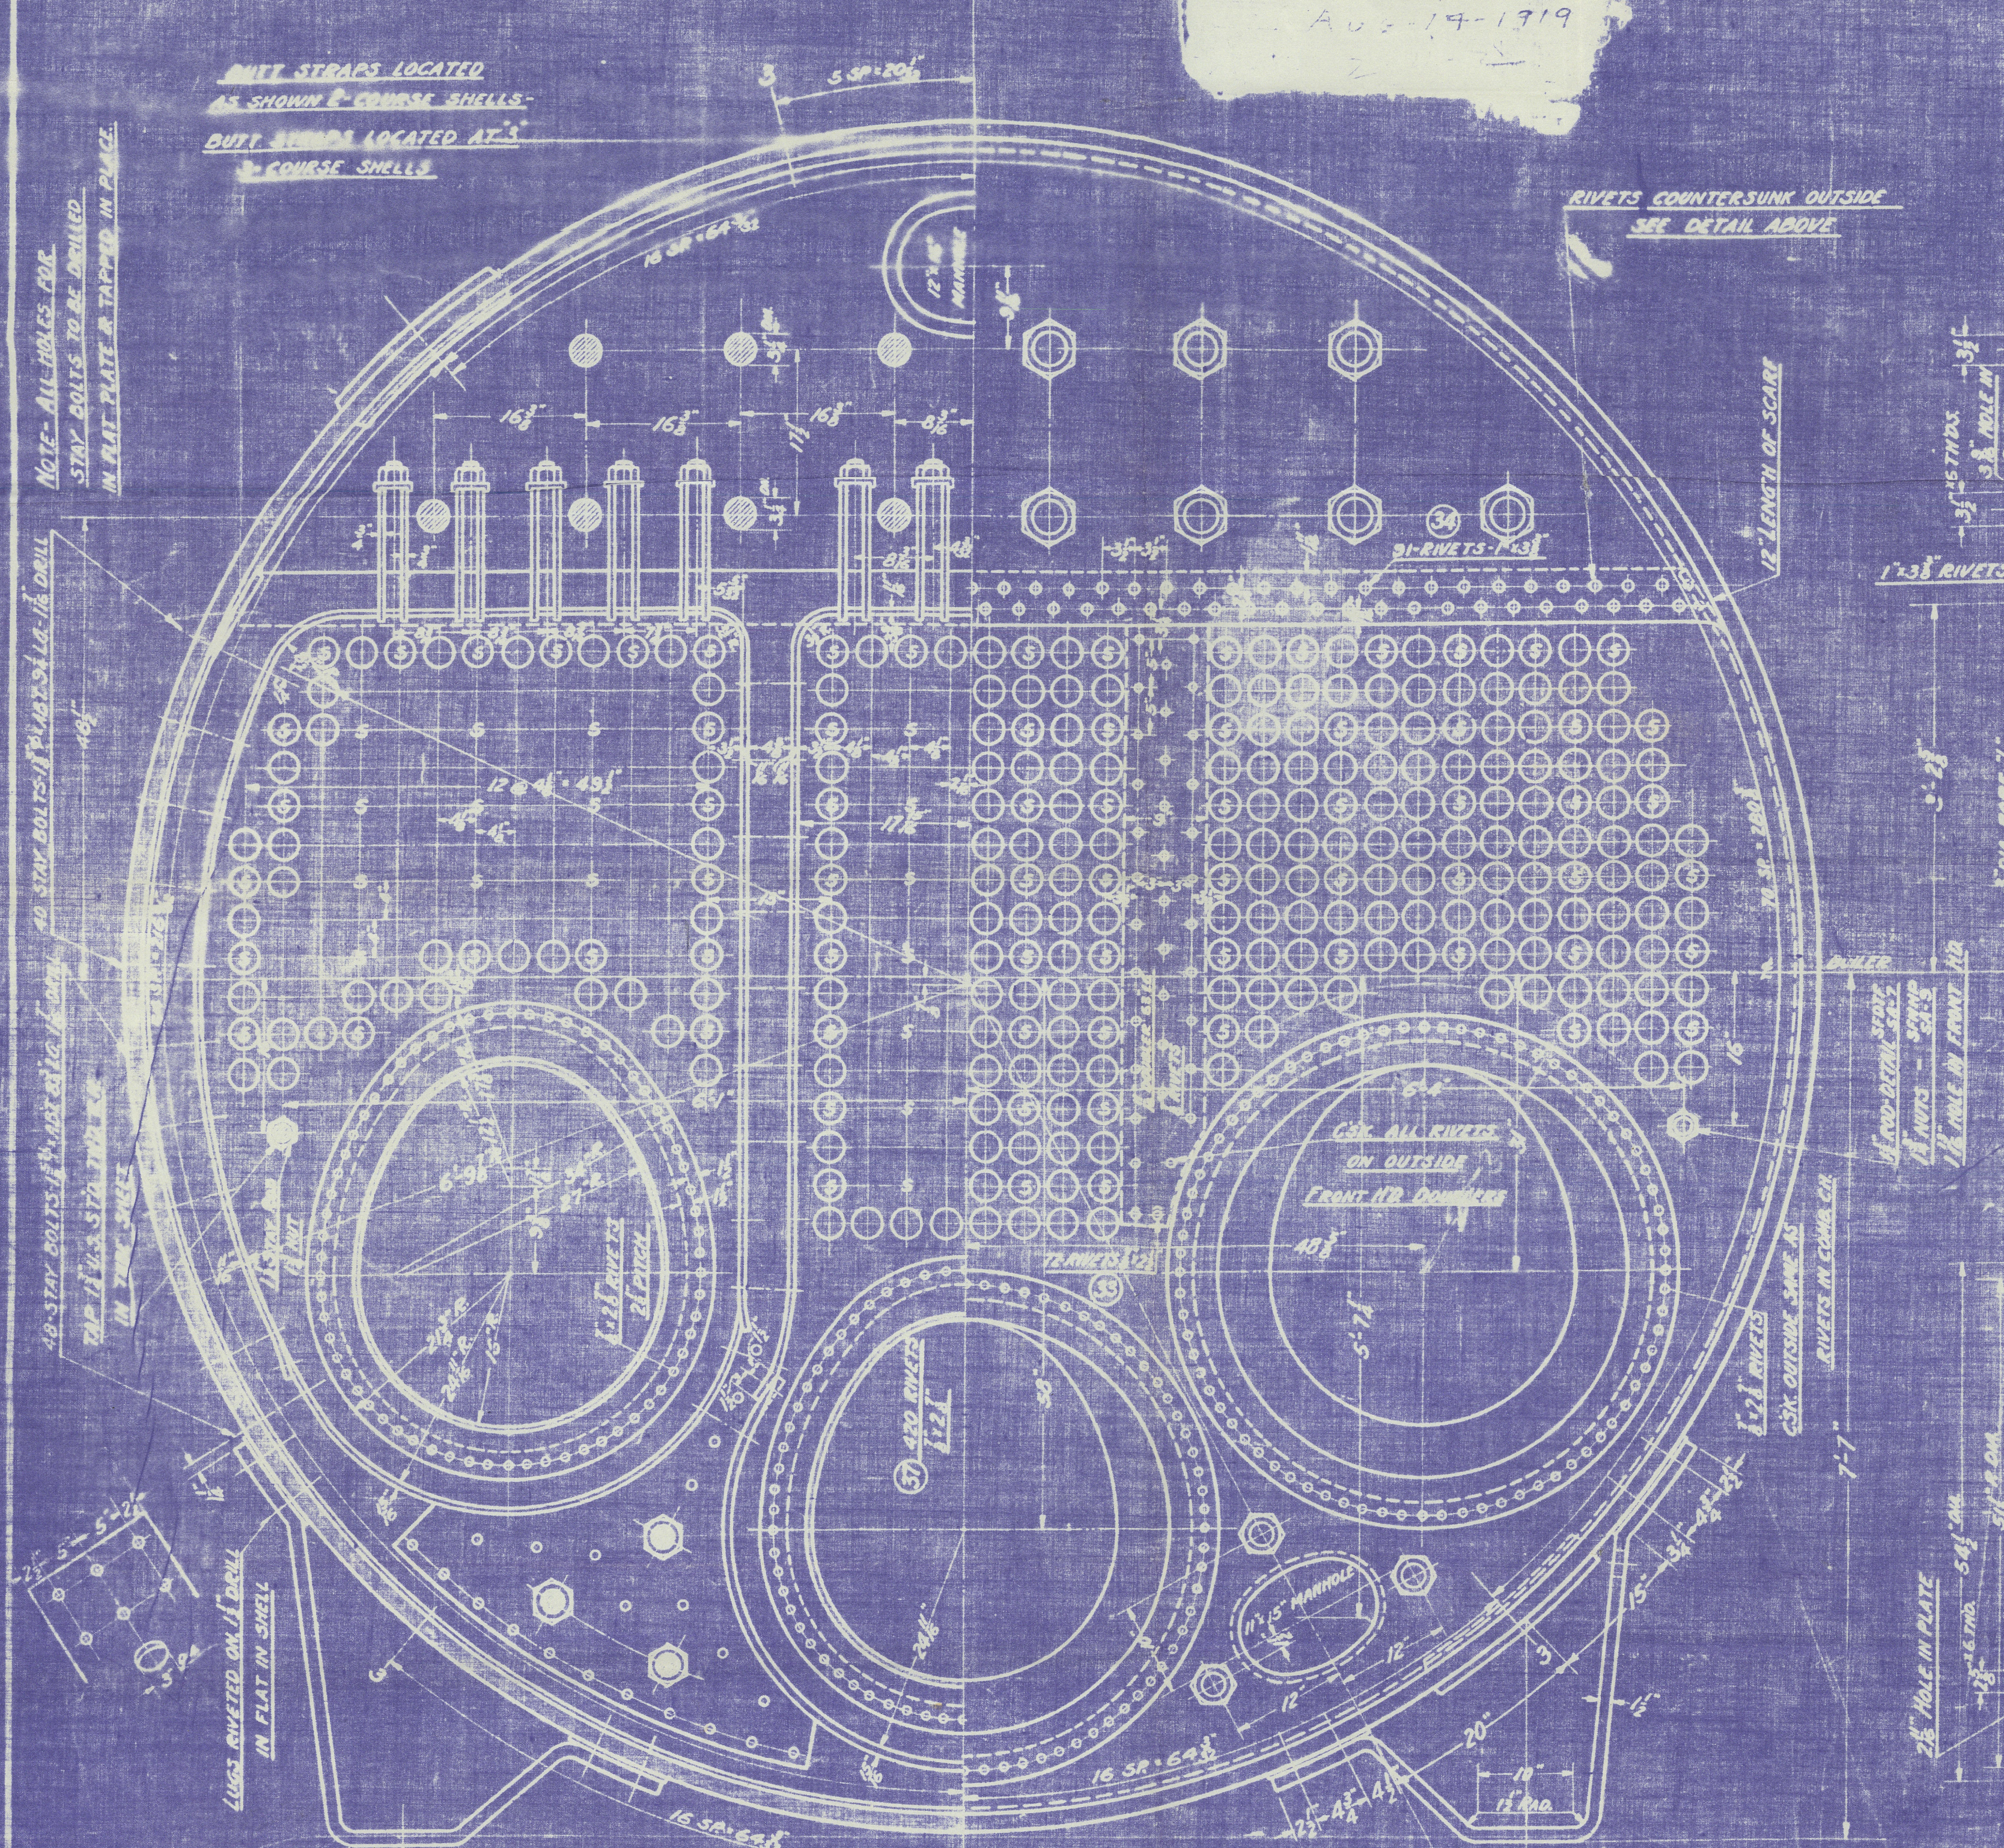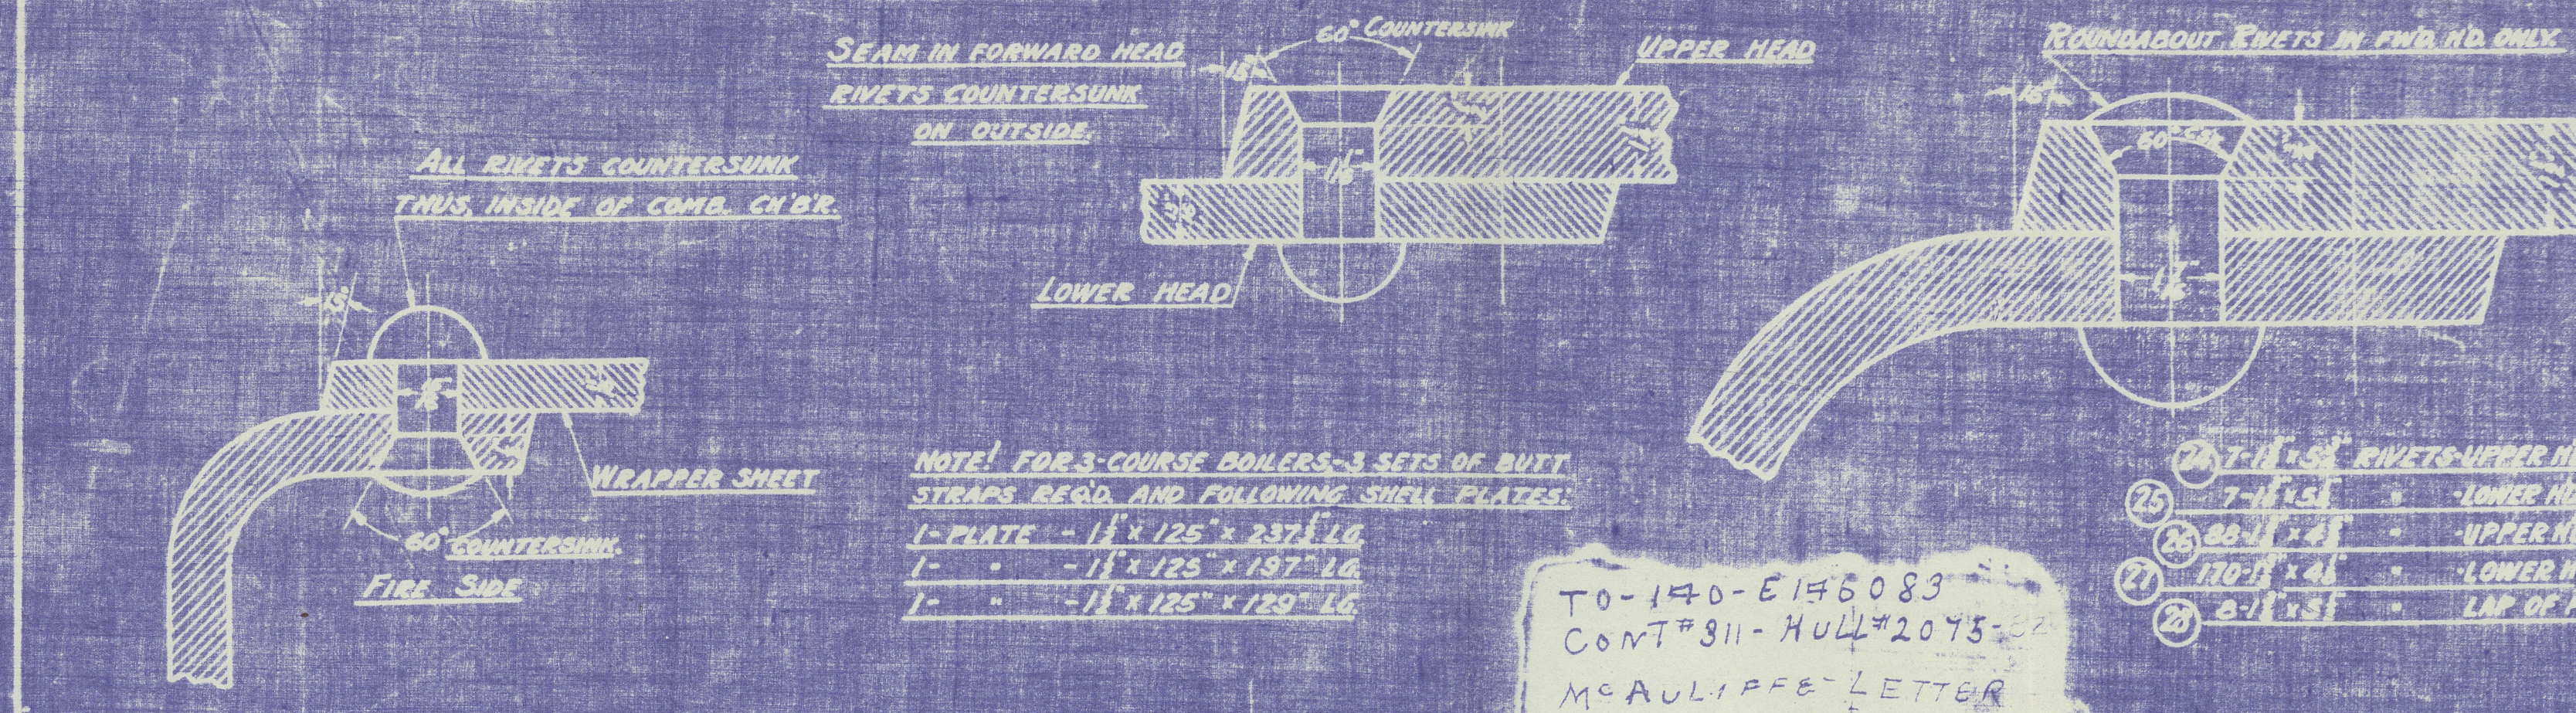


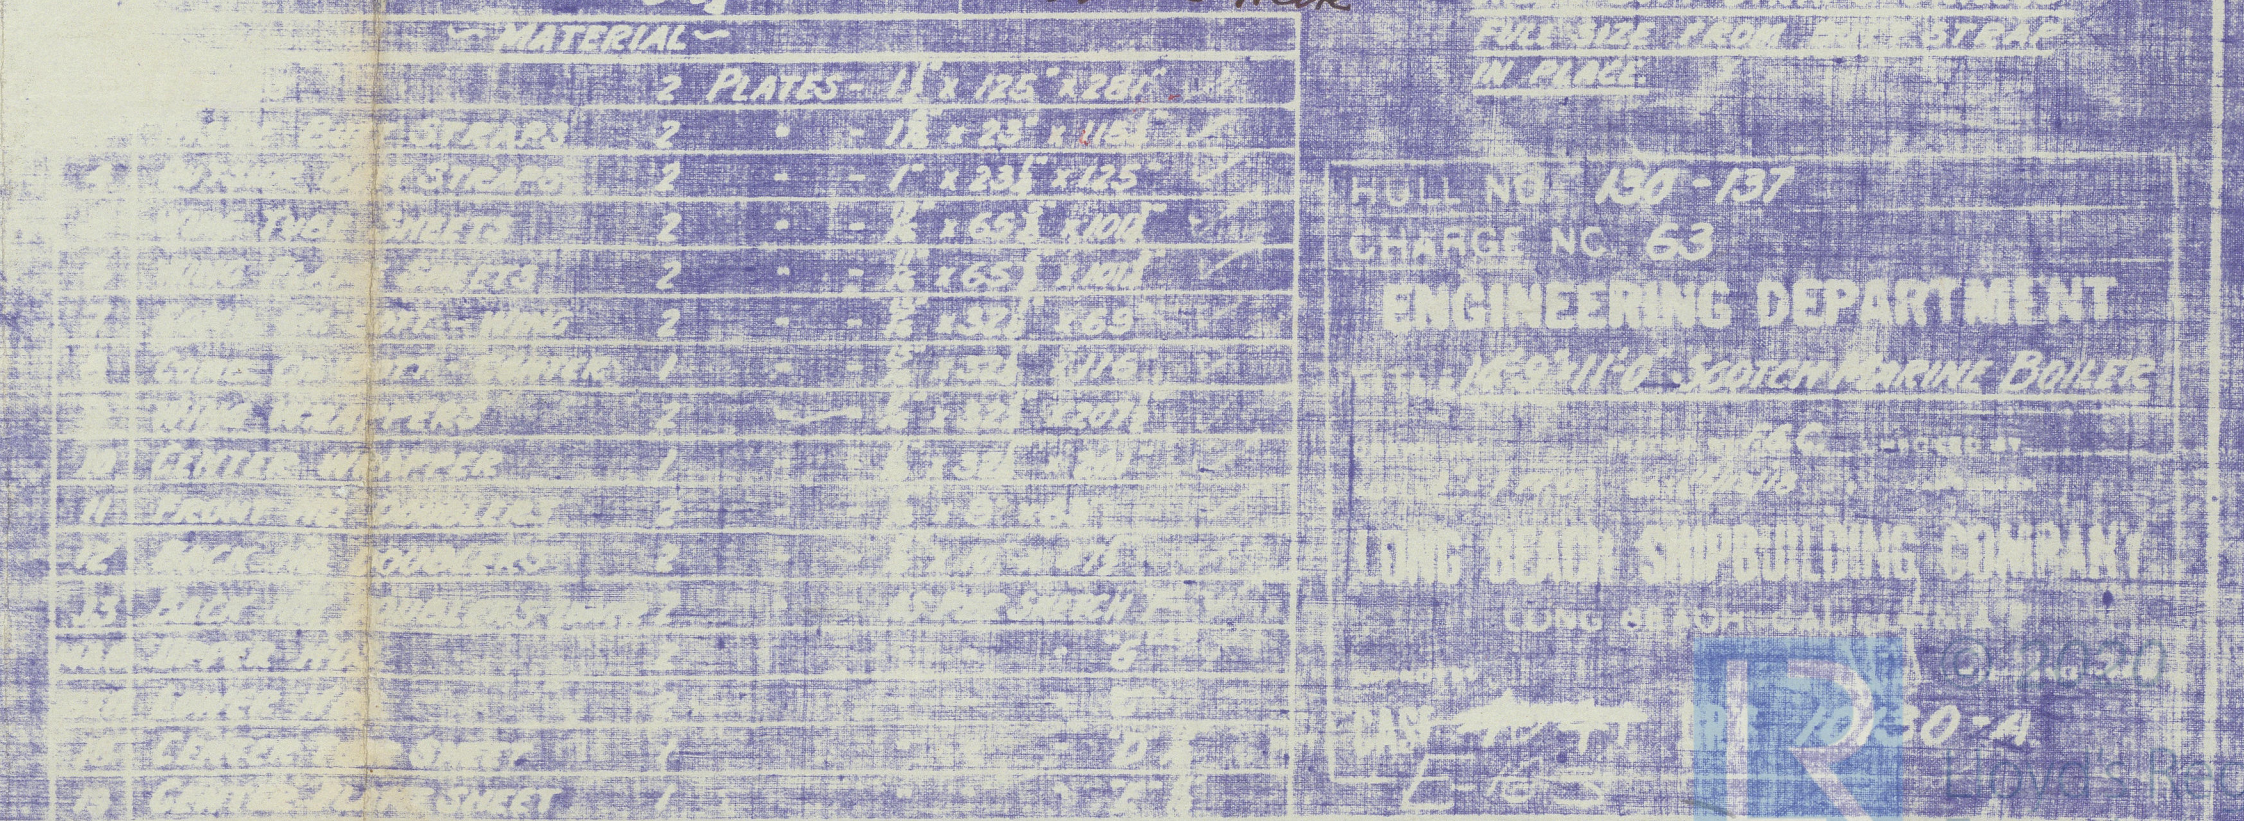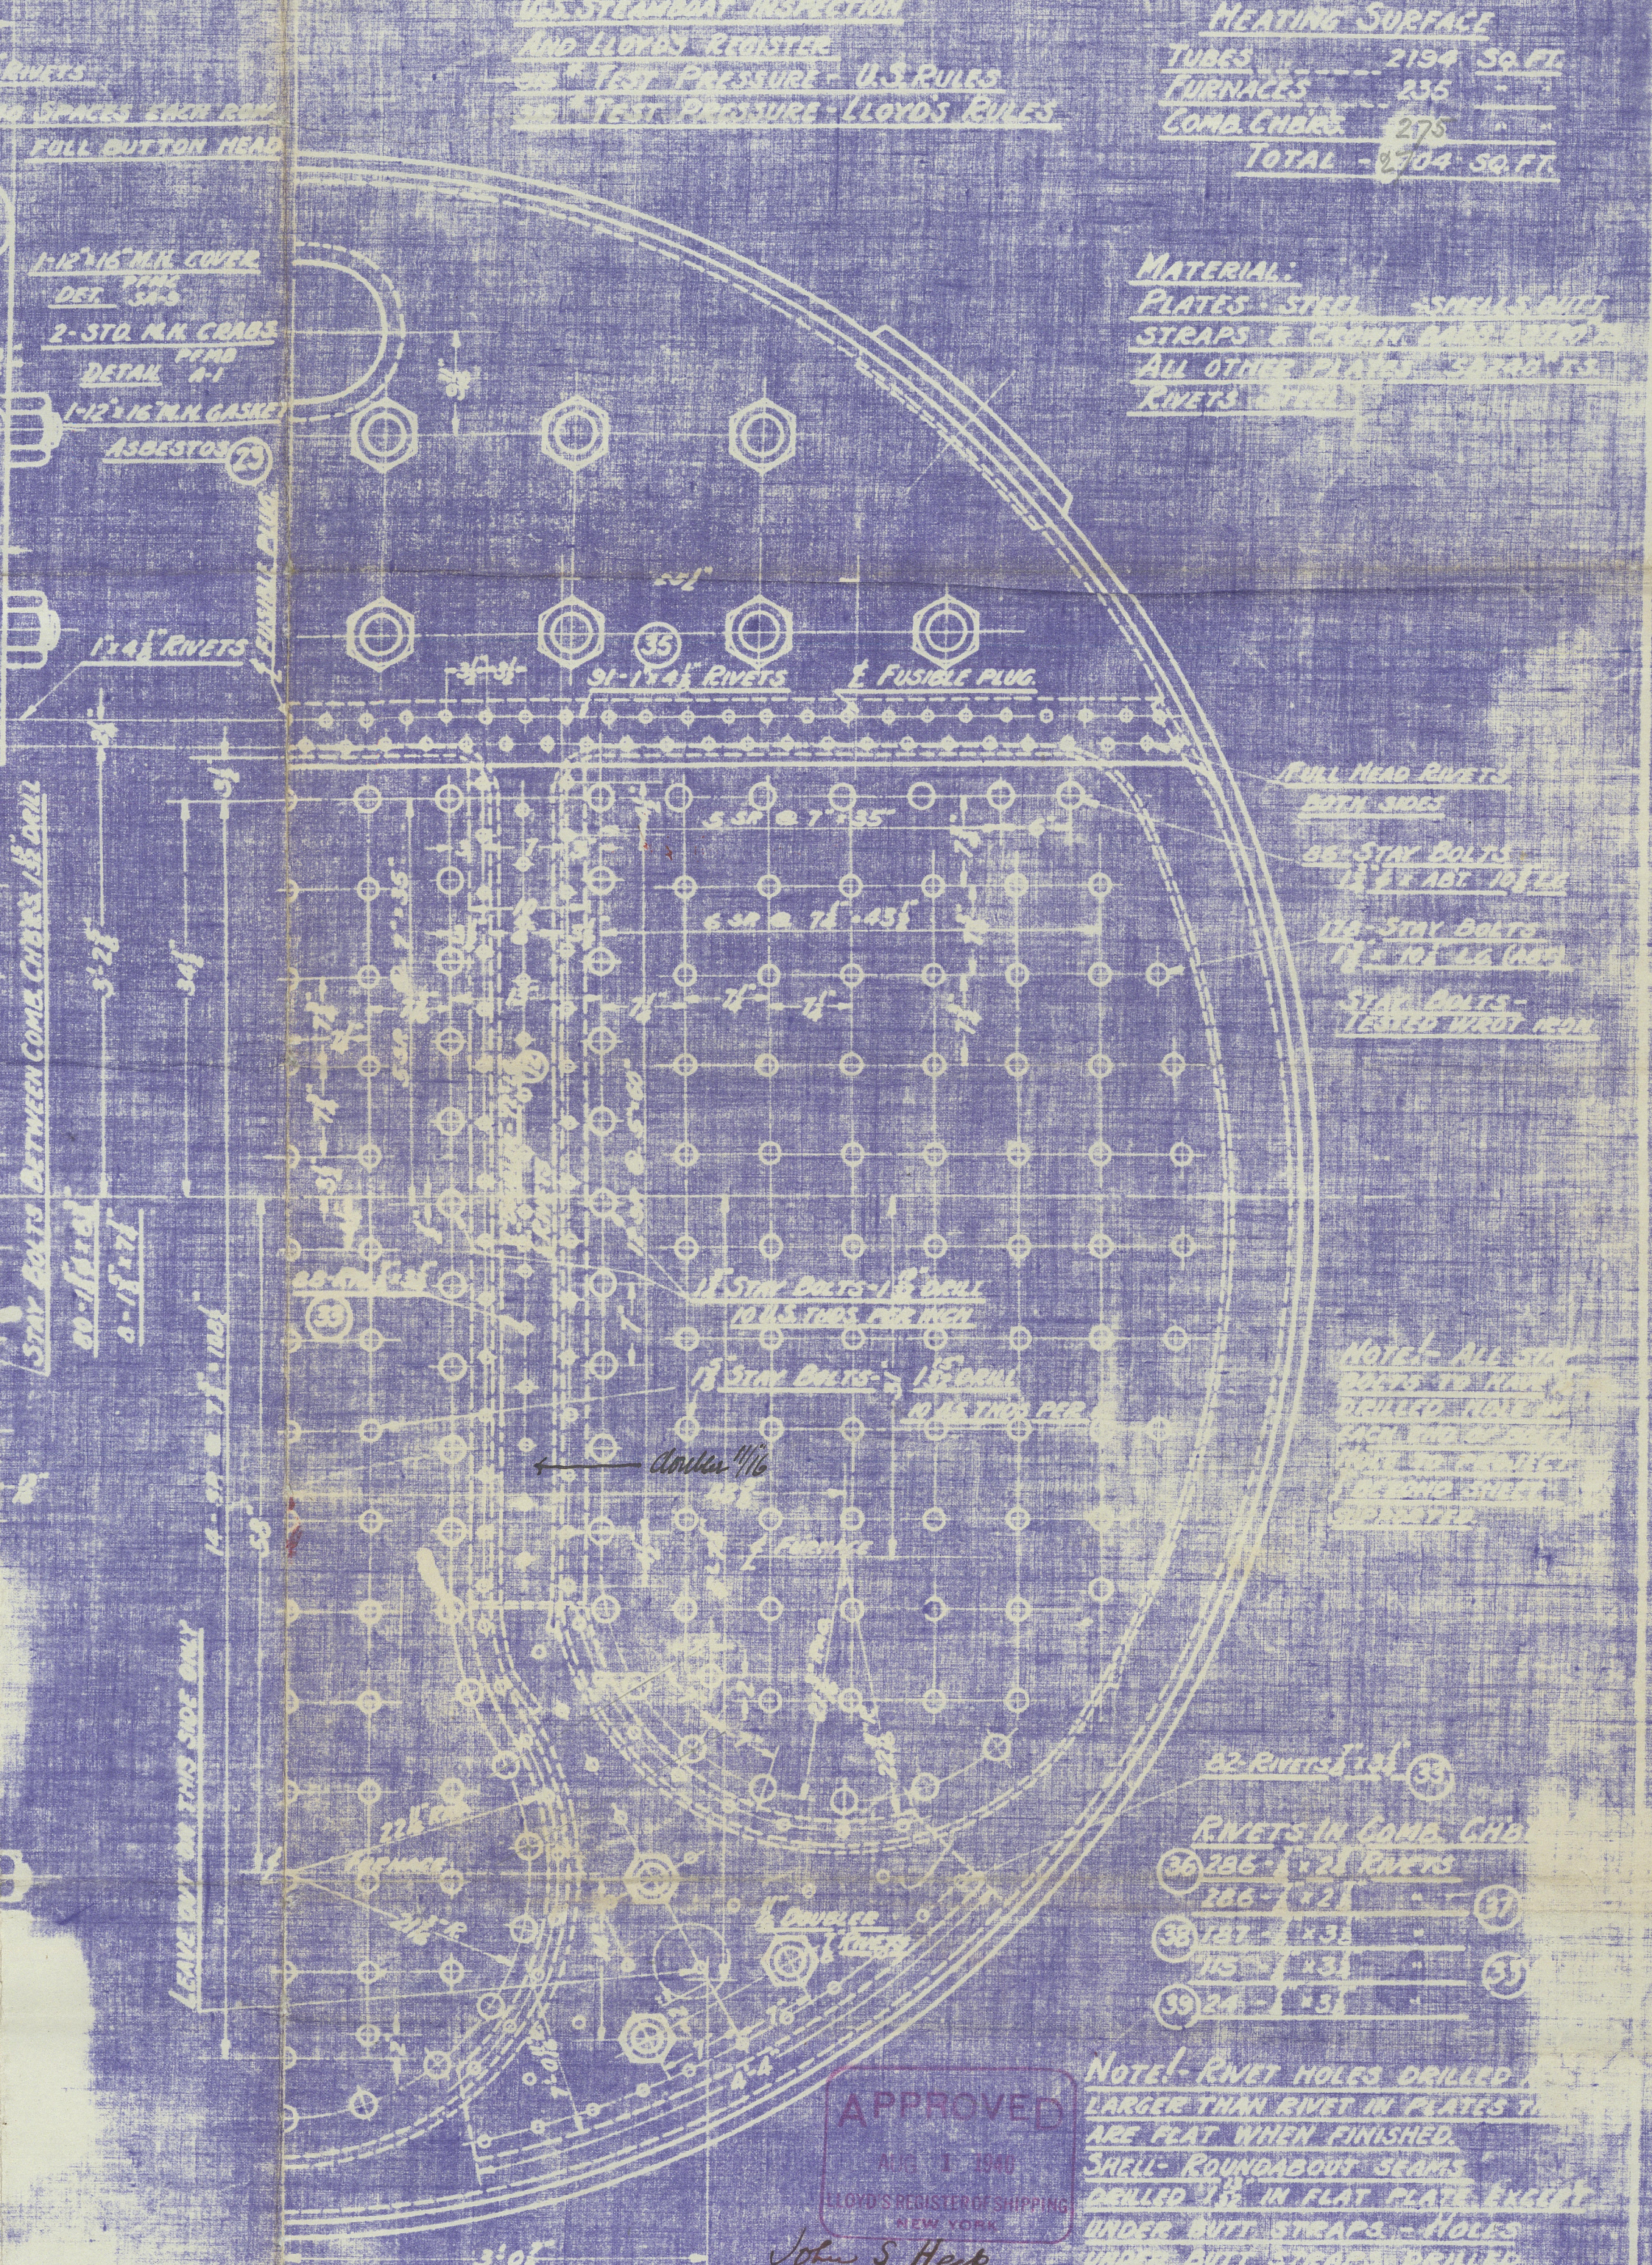


BLUE PRINTS ISSUED TO	
NO.	DATE
1	1910
2	1910
APPROVED
 J. S. Heck

HULL NO. 157-157
 CHARGE NO. 63
 ENGINEERING DEPARTMENT
 McCullough & Sons
 LONG BEACH SHIPBUILDING COMPANY
 LONG BEACH, CALIFORNIA